


STREETCAR BOAT "MINNEHAHA"

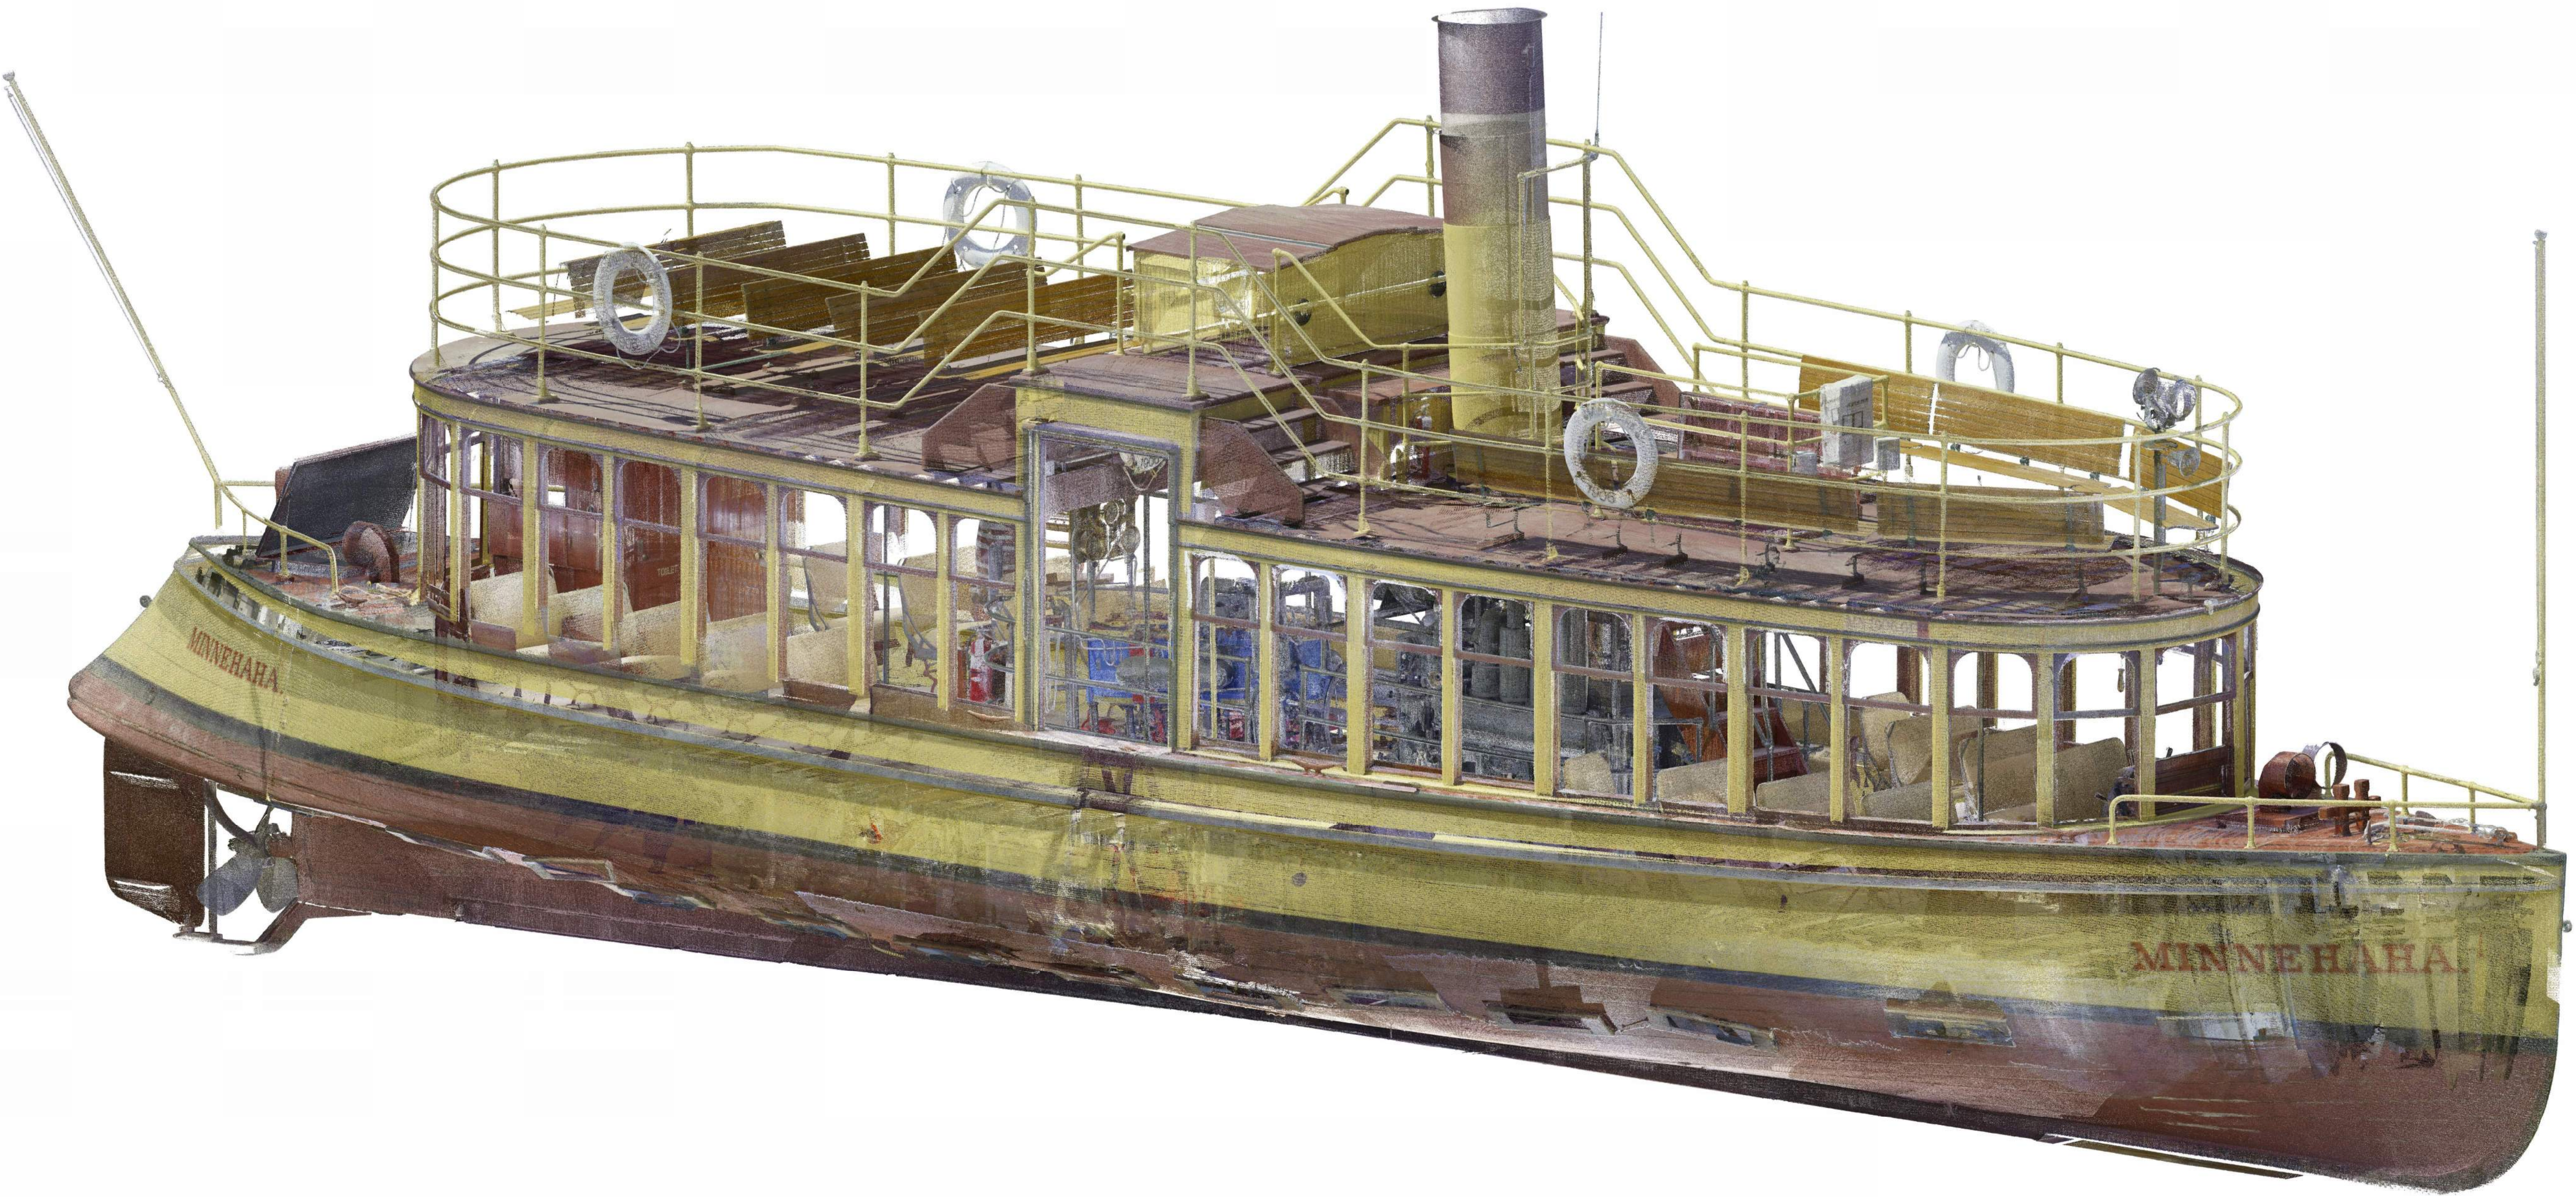


APPROVED BY:	PROJECT NO.:	REV. NO.:	REV. DESCRIPTION:	REV. DATE:
	23018	0	SCAN DATE - MAY 2022	15SEP23
	PROJECT NAME: STREET CAR BOAT "MINNEHAHA"			
	PROJECT ADDRESS: EXCELSIOR, MINN		CLIENT: LAKE MINNETONKA MUSEUM	
	SHEET NAME: COVER SHEET			SHEET NO.: C01

DRAWN BY:
Dan Starr & Jason Meyer
O: 763-276-1035
quote@scanstarllc.com

11040 183rd Circle NW
Suite AA
Elk River, MN 55330
scanstarllc.com

- o Pointclouds
- o Bid Documents
- o Site Mapping
- o Resource Management

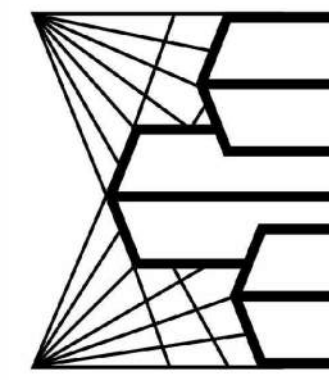


SCANSTAR
DATA DRIVEN & GEOSPATIAL SOLUTIONS


STEAMBOAT

MINNEHAHA

1906


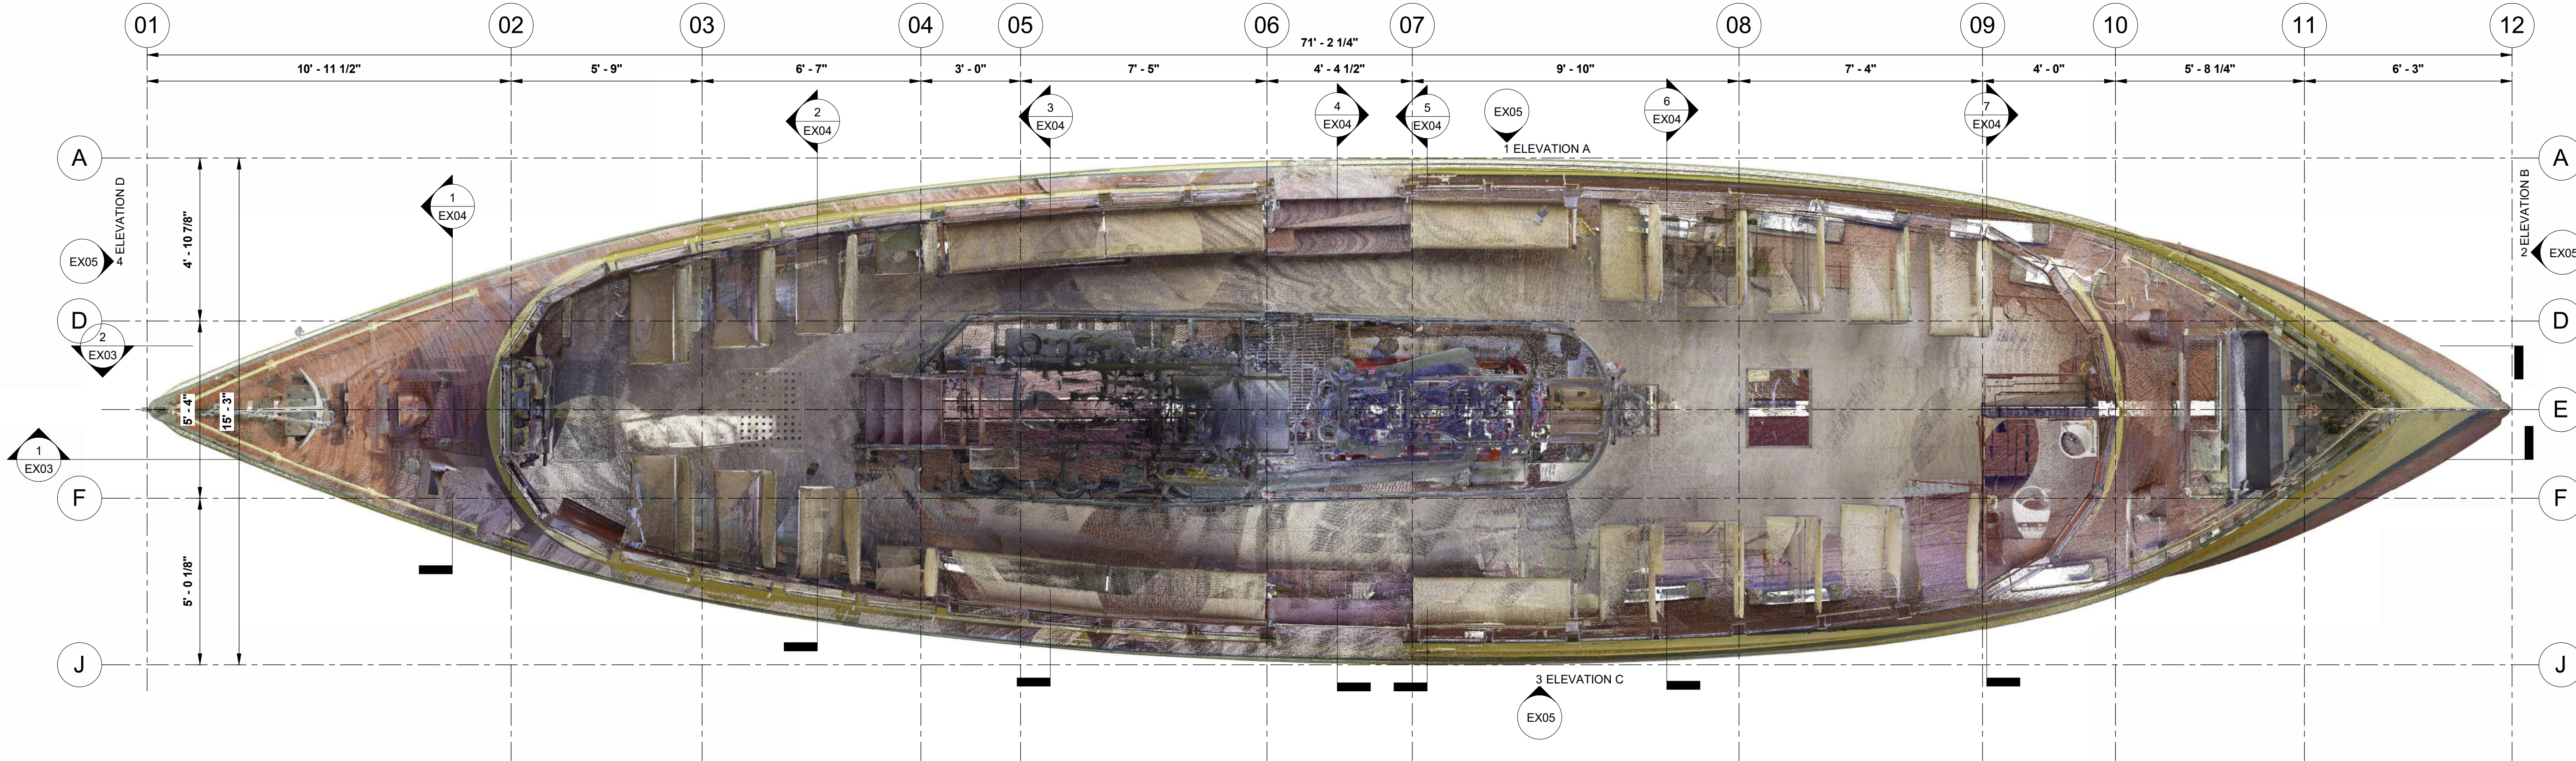


1 T/ MAIN DECK
EX01 3/8" = 1'-0"

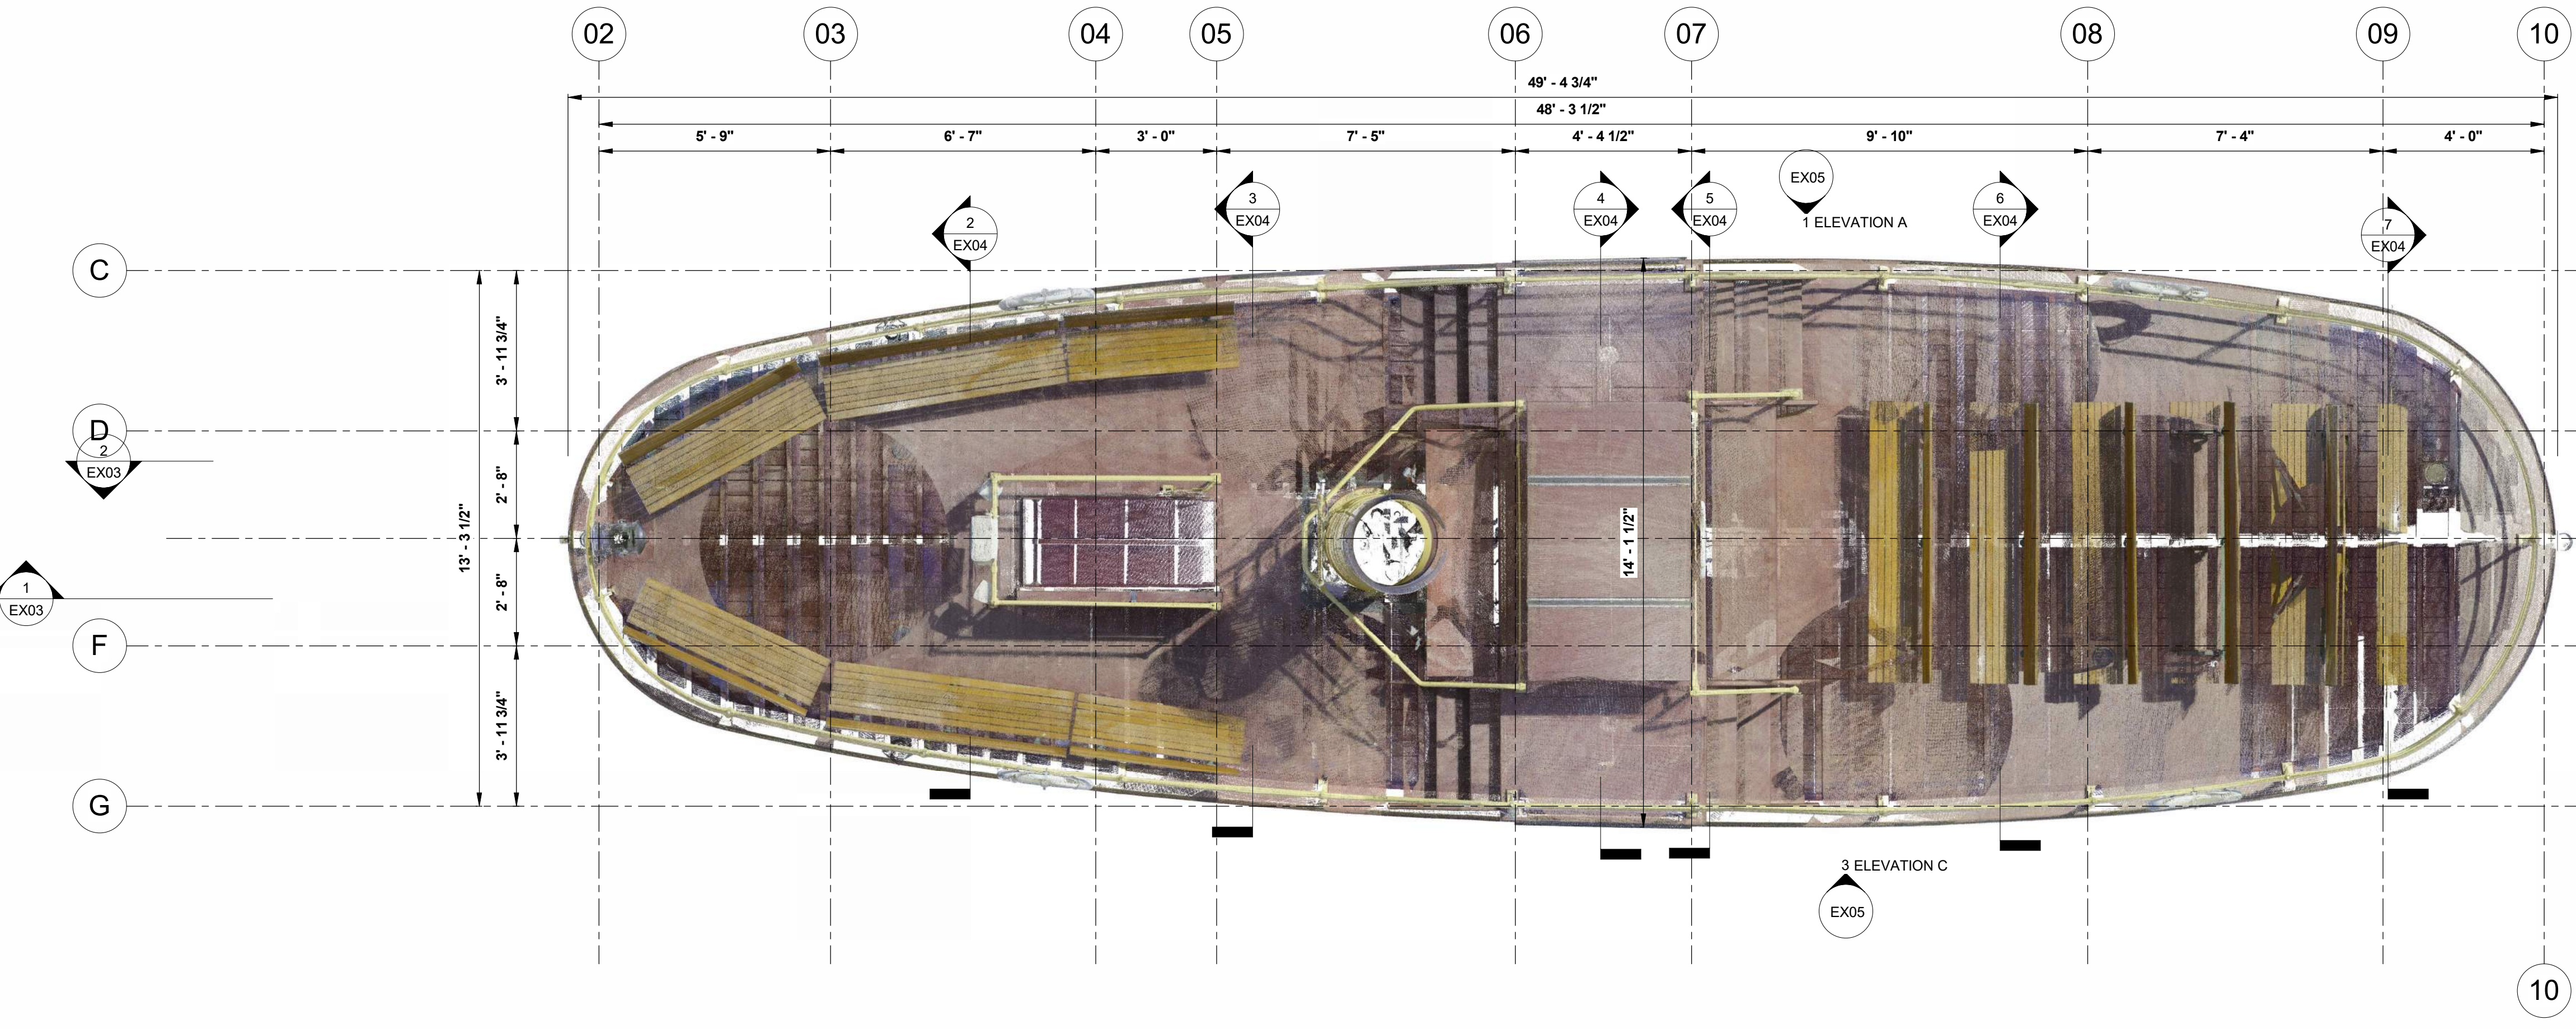

2 T/ UPPER DECK
EX01 3/8" = 1'-0"

APPROVED BY:	PROJECT NO. 23018	REV. NO. 0	REV. DATE - MAY 2022	REV. DATE: 15SEP23
	PROJECT NAME: STREET CAR BOAT "MINNEHAHA"			
	CLIENT: LAKE MINNETONKA MUSEUM			
	PROJECT ADDRESS: EXCELSIOR, MINN			
DRAWN BY: Dan Starr & Jason Meyer				
O: 763-276-1035				
mailto:scansstar@scansstarllc.com				
11040 183rd Circle NW				
Suite AA				
Elk River, MN 55330				
scansstarllc.com				
<ul style="list-style-type: none"> o Pointclouds o Bid Documents o Site Mapping o Resource Management 				
PLANS AT DECK AND UPPER DECK				SHEET NO. EX01

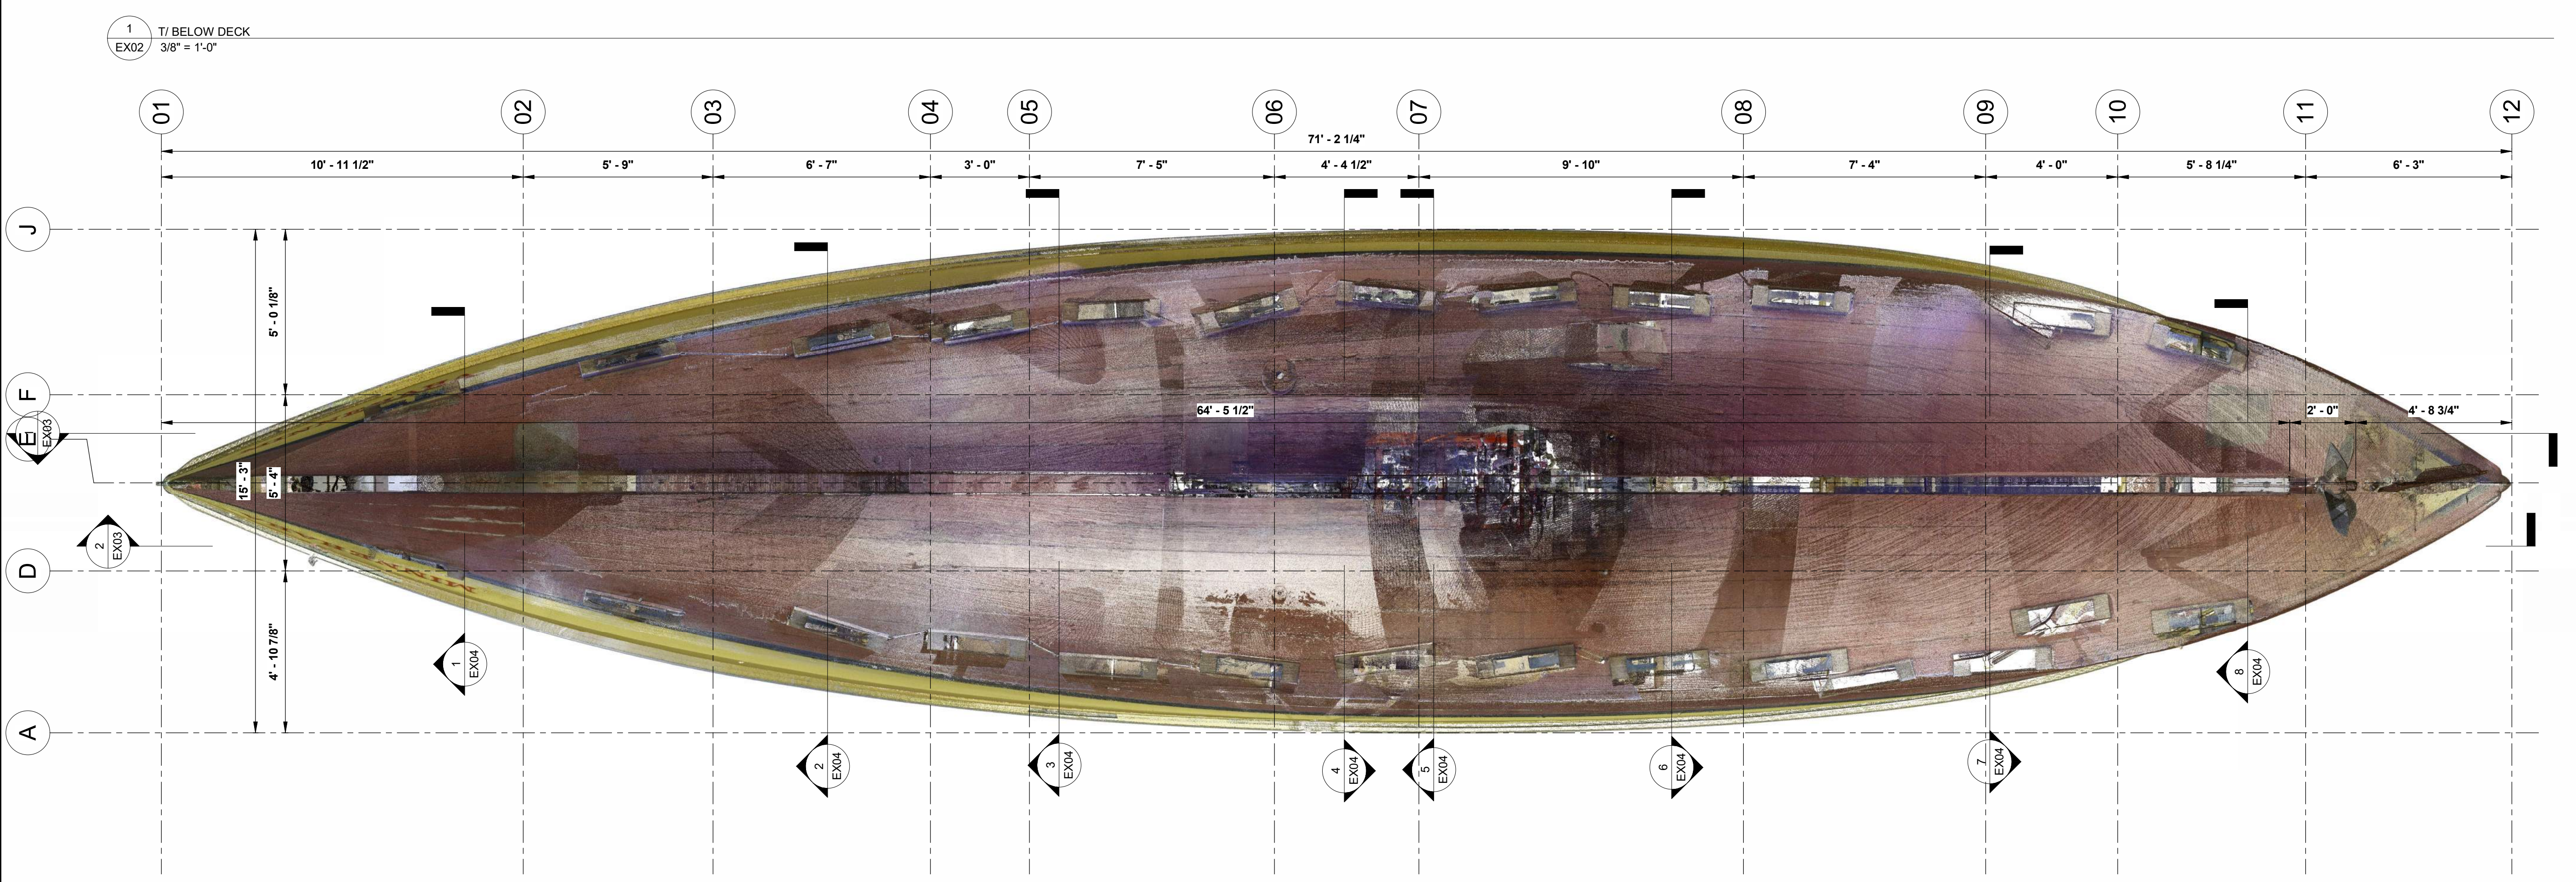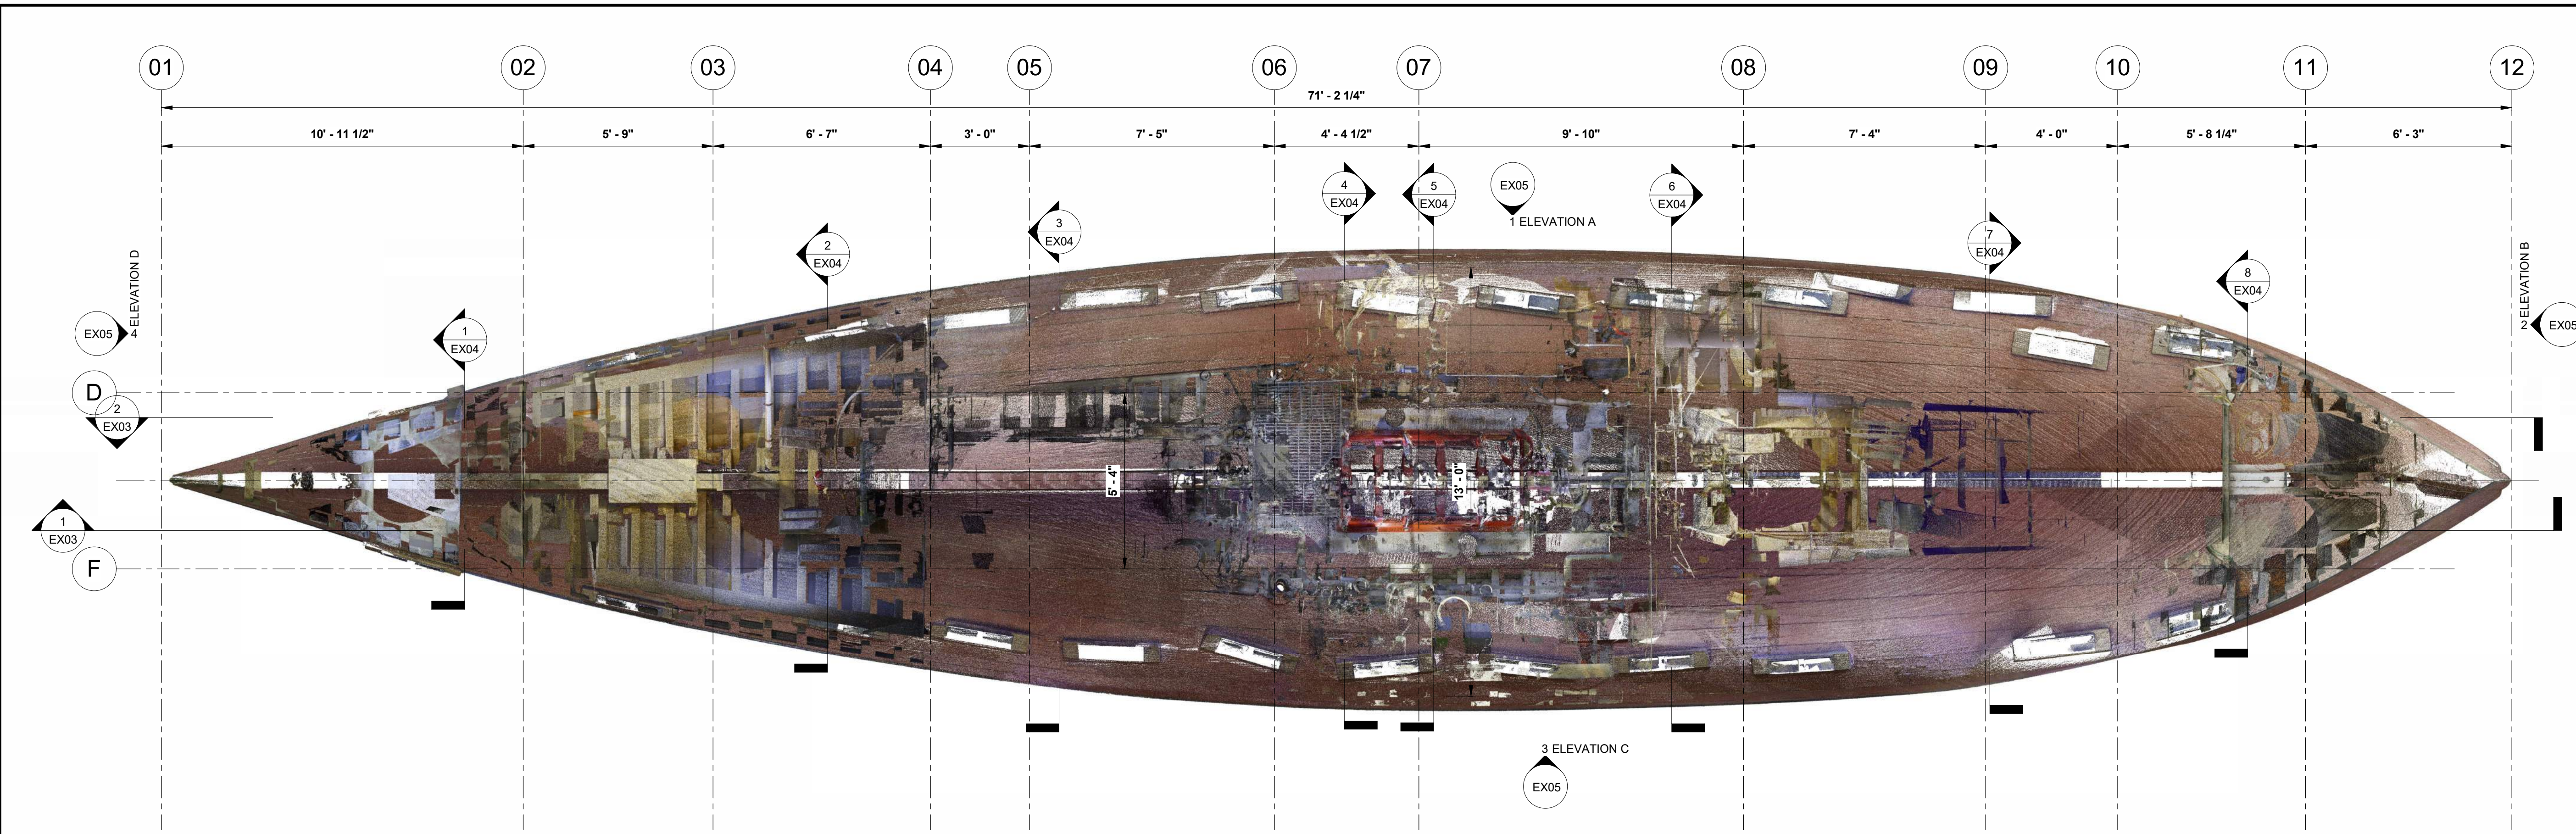


BOTTOM OF HULL - LOOKING UP

1
EX02
T/ BELOW DECK
3/8" = 1'-0"

PROJECT NO: 23018	REV. NO: 0	REV. DESCRIPTION: SCAN DATE - MAY 2022	REV. DATE: 15SEP23
PROJECT NAME: STREET CAR BOAT "MINNEHAHA"		CLIENT: LAKE MINNETONKA MUSEUM	
PROJECT ADDRESS: EXCELSIOR, MINN		SHEET NAME: PLAN - BELOW DECK & BTM OF HULL	
DRAWN BY: Dan Starr & Jason Meyer O: 763-276-1035 quote@scansstarllc.com		APPROVED BY:	
11040 183rd Circle NW Suite AA Elk River, MN 55330 scansstarllc.com			
<ul style="list-style-type: none"> o Pointclouds o Bid Documents o Site Mapping o Resource Management 			
EX02			



1 SECTION LOOKING STARBOARD
EX03 3/8" = 1'-0"


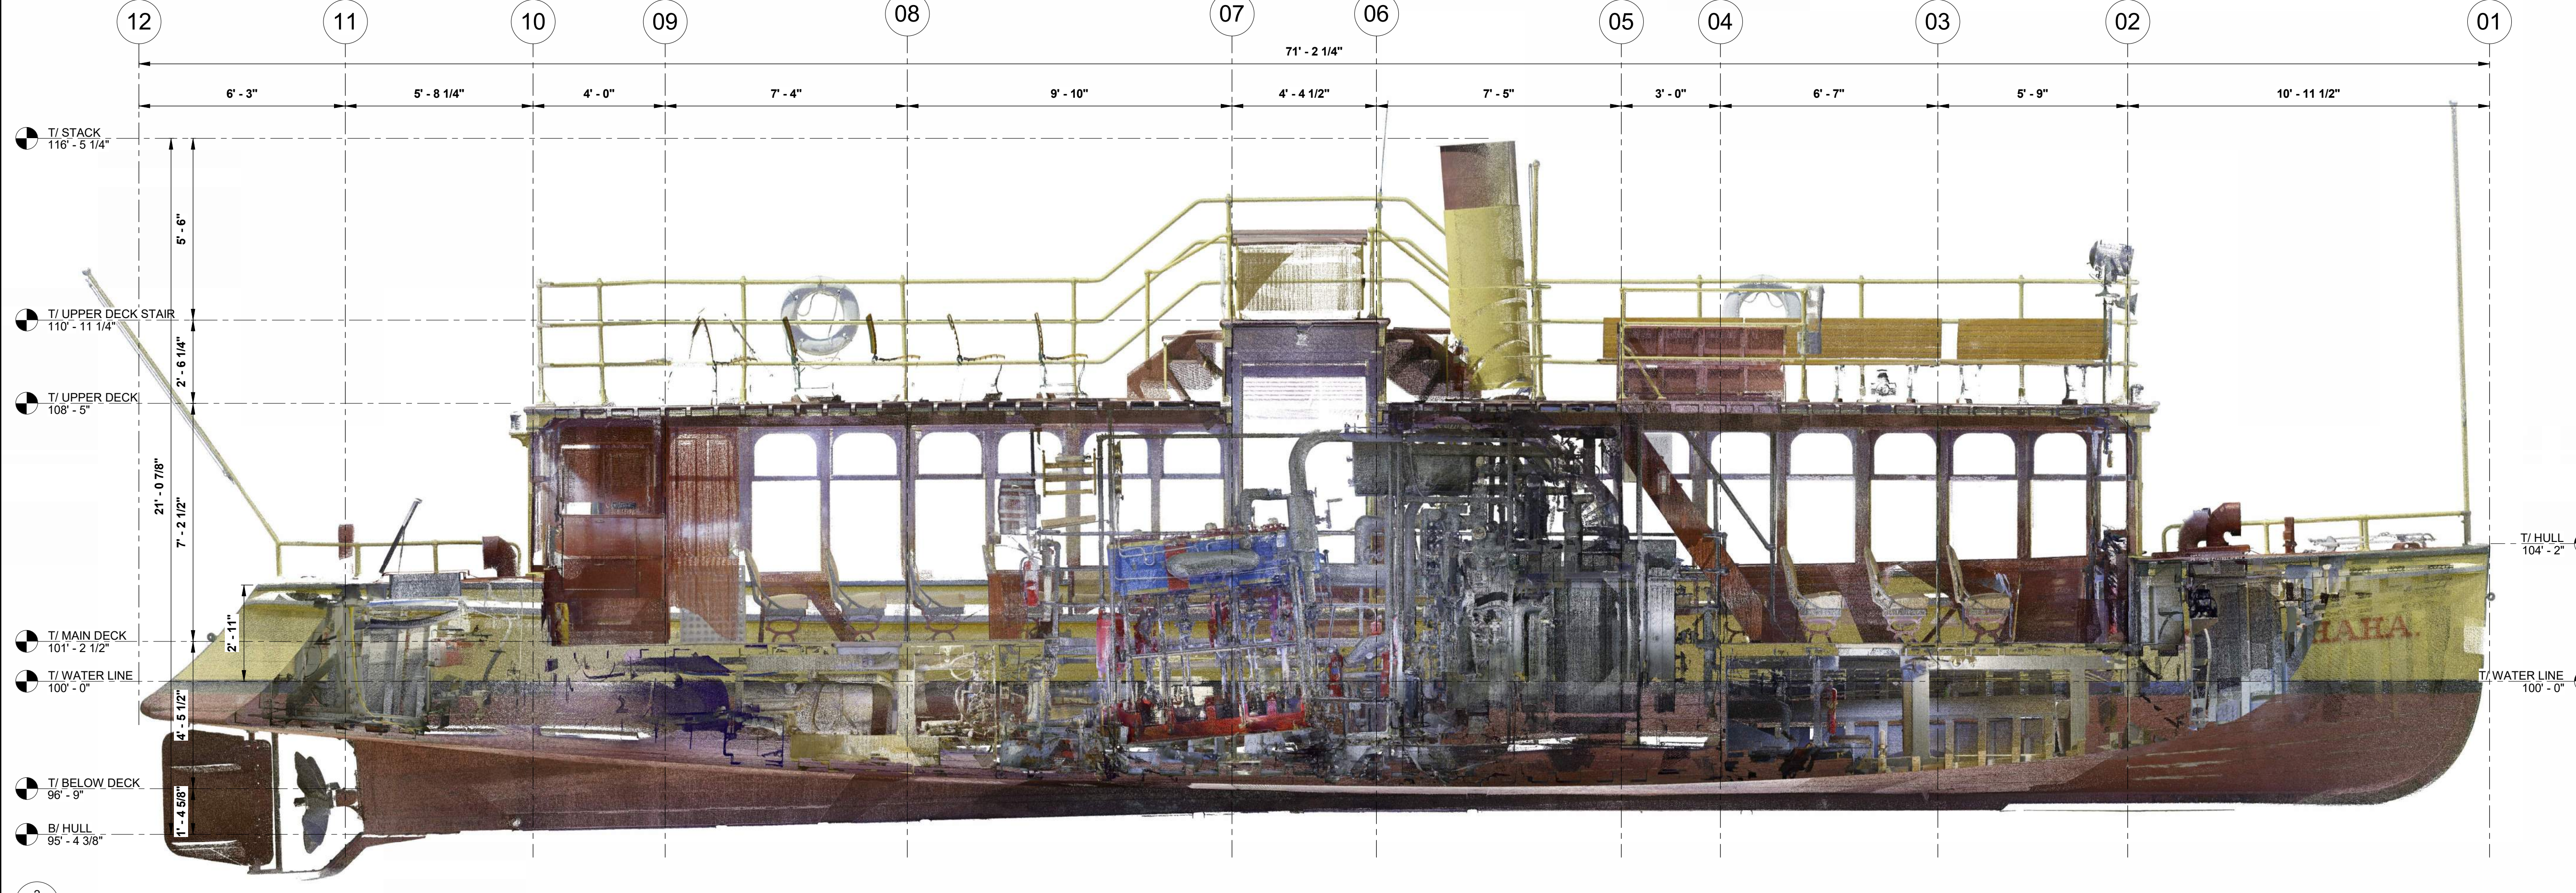


2 SECTION LOOKING PORT
EX03 3/8" = 1'-0"

REV. DATE: 15SEP23
 REV. DESCRIPTION: SCAN DATE - MAY 2022
 PROJECT NO: 23018
 REV. NO: 0
 PROJECT NAME: STREET CAR BOAT "MINNEHAHA"
 CLIENT: LAKE MINNETONKA MUSEUM
 PROJECT ADDRESS: EXCELSIOR, MINN
 SHEET NO: EX03
 SECTIONS - STARBOARD AND PORT

SCANSTAR
 DATA DRIVEN & GEOSPATIAL SOLUTIONS
 DRAWN BY: Dan Starr & Jason Meyer
 O: 763-276-1035
 quote@scansstarllc.com
 11040 183rd Circle NW
 Suite AA
 Elk River, MN 55330
 scansstarllc.com
 o Pointclouds
 o Bid Documents
 o Site Mapping
 o Resource Management

APPROVED BY:
STEAMBOAT MINNEHAHA
 1906

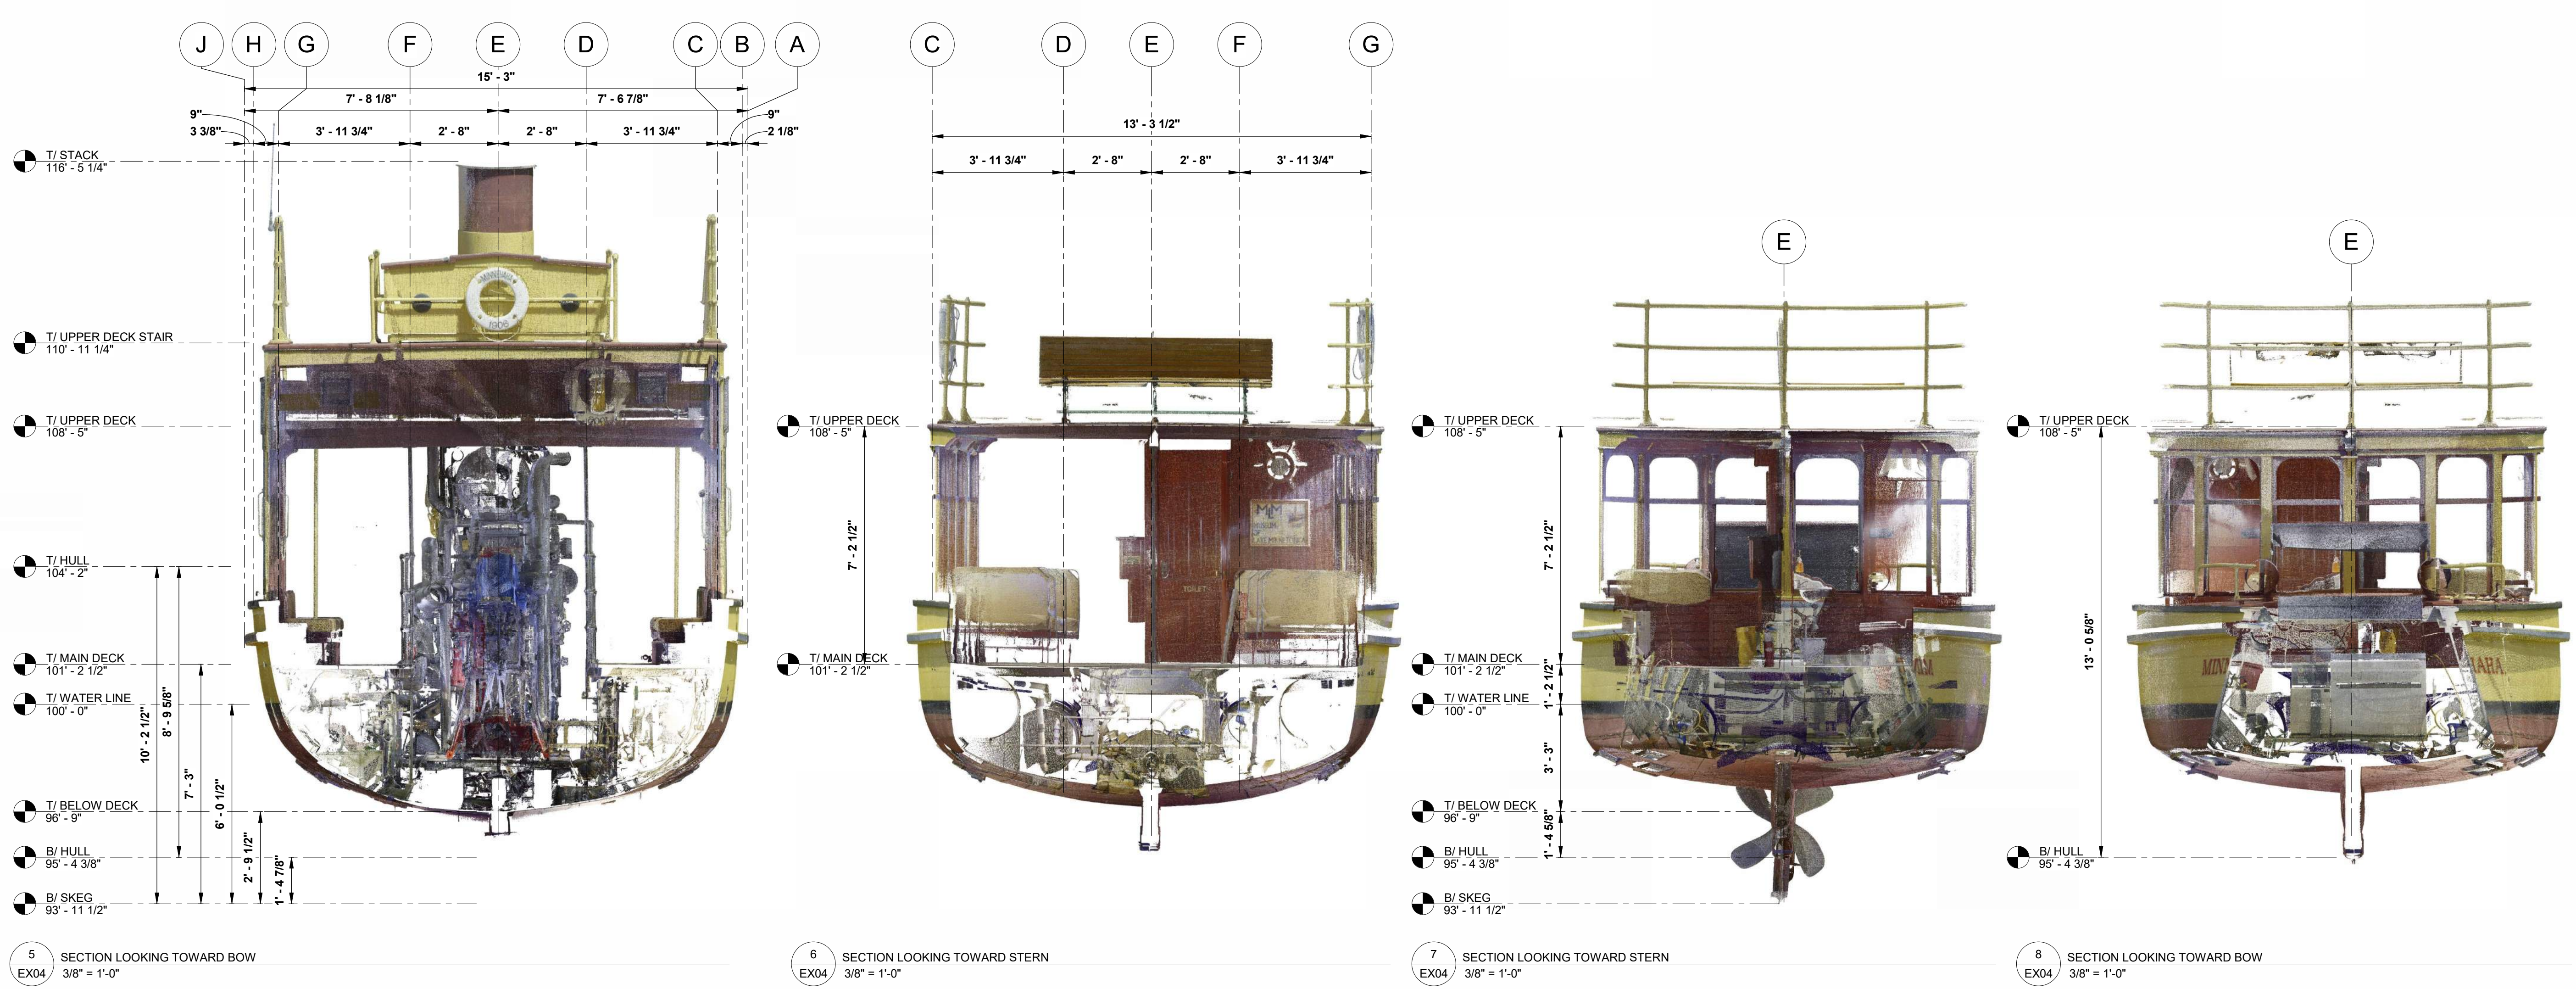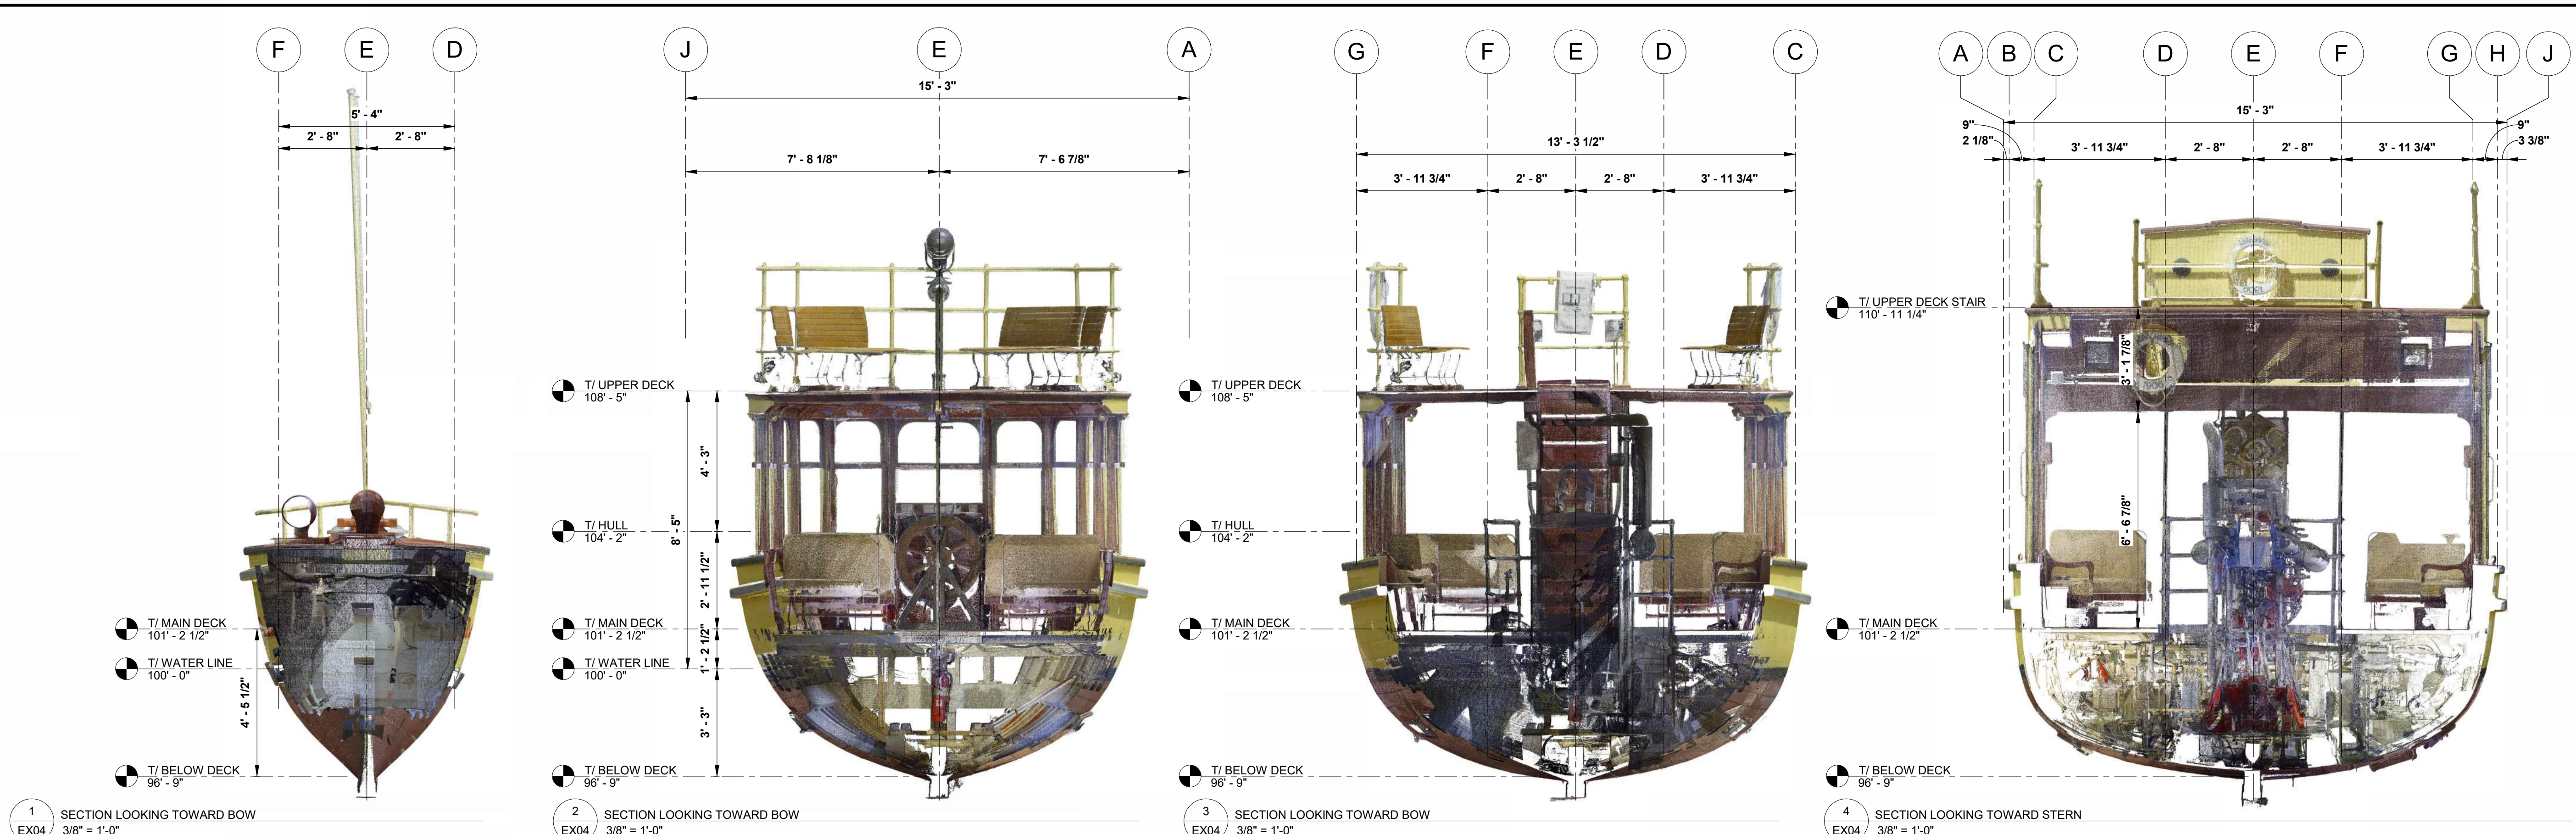

REV. DATE:	15SEP23
REV. DESCRIPTION:	SCAN DATE - MAY 2022
REV. NO.:	0
PROJECT NO.:	23018
PROJECT NAME:	STREET CAR BOAT "MINNEHAHA"
CLIENT:	LAKE MINNETONKA MUSEUM
PROJECT ADDRESS:	EXCELSIOR, MINN
SHEET NO.:	EX04


APPROVED BY:

DRAWN BY:
Dan Starr & Jason Meyer
O: 763-276-1035
quote@scansarlic.com
11040 183rd Circle NW
Suite AA
Elk River, MN 55330
scansarlic.com


o Pointclouds
o Bid Documents
o Site Mapping
o Resource Management

SCANSTAR
DATA DRIVEN & GEOSPATIAL SOLUTIONS


STEAMBOAT
MINNEHAHA
1906

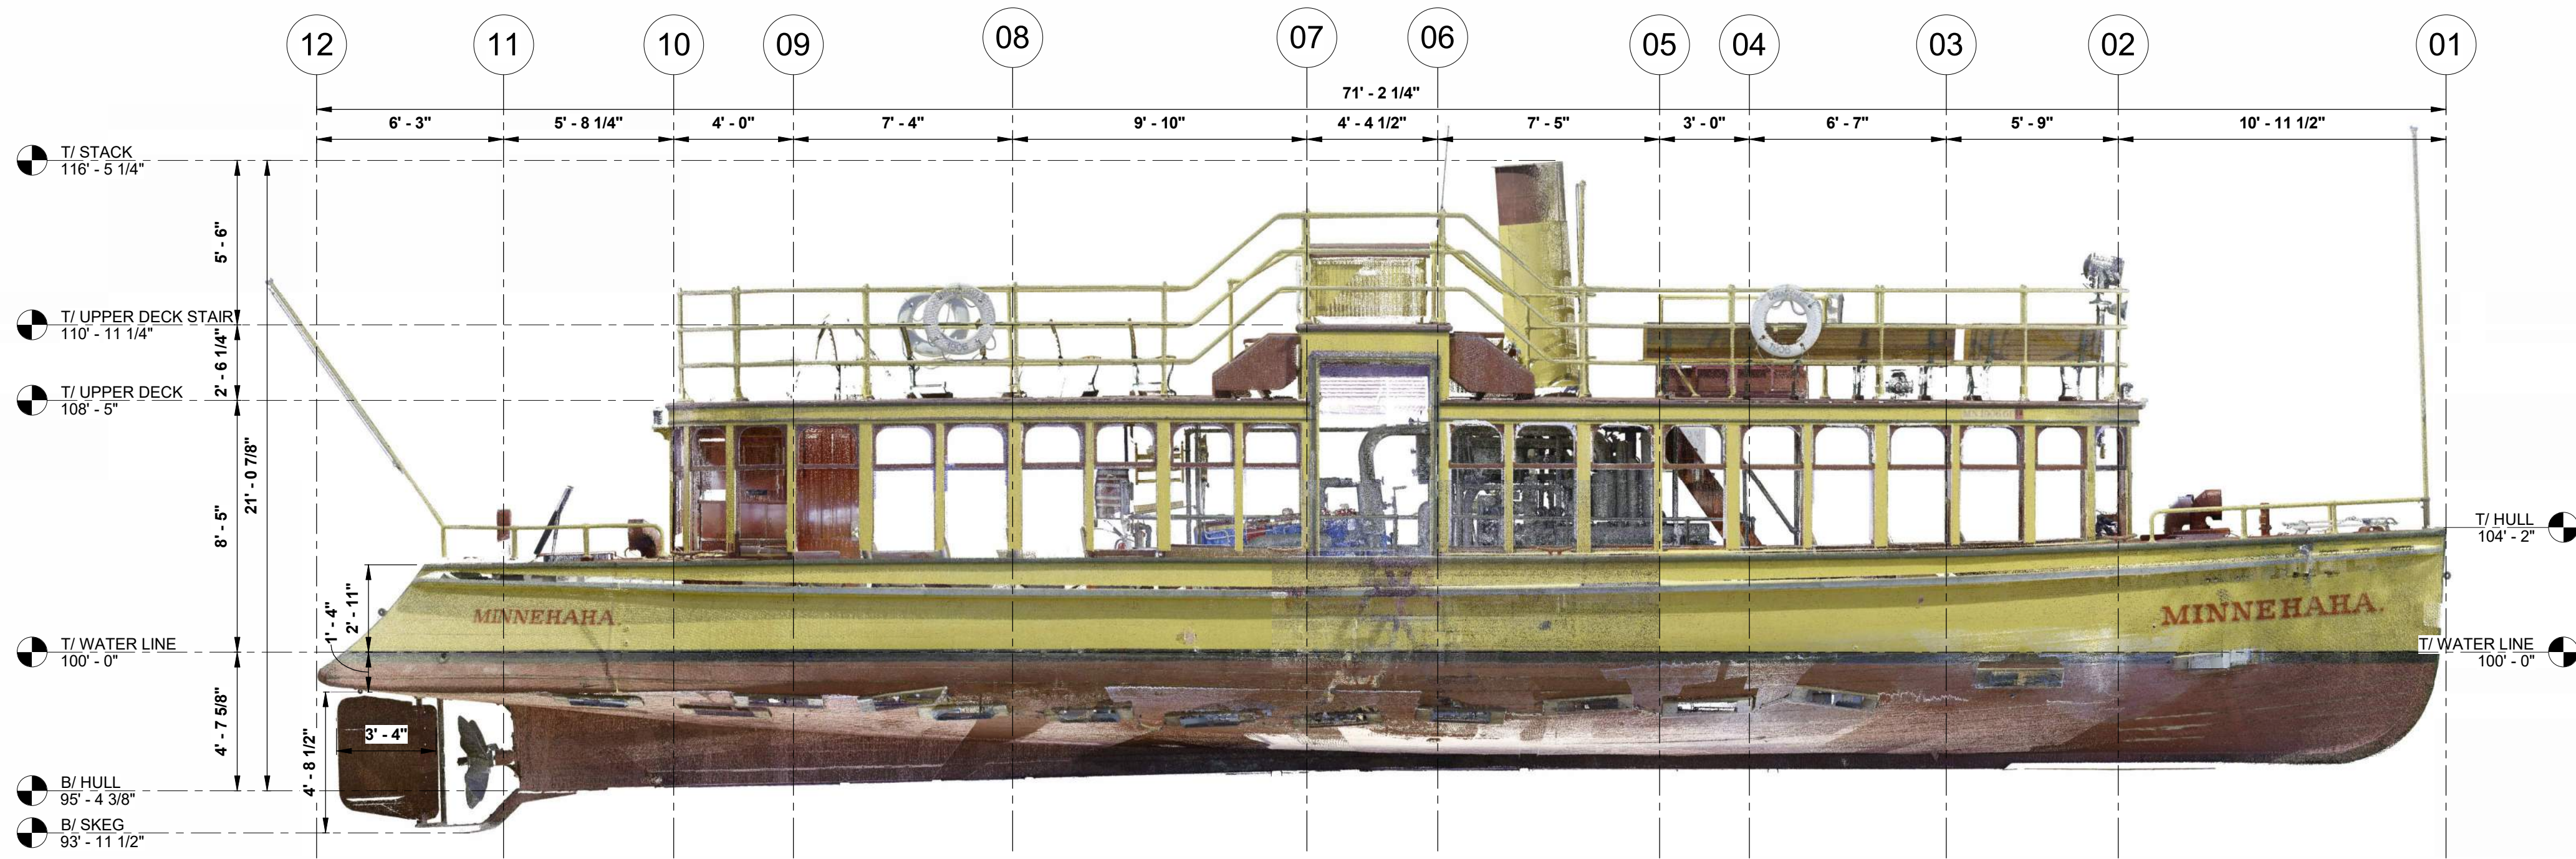


1 ELEVATION LOOKING AT STARBOARD SIDE
1/4" = 1'-0"

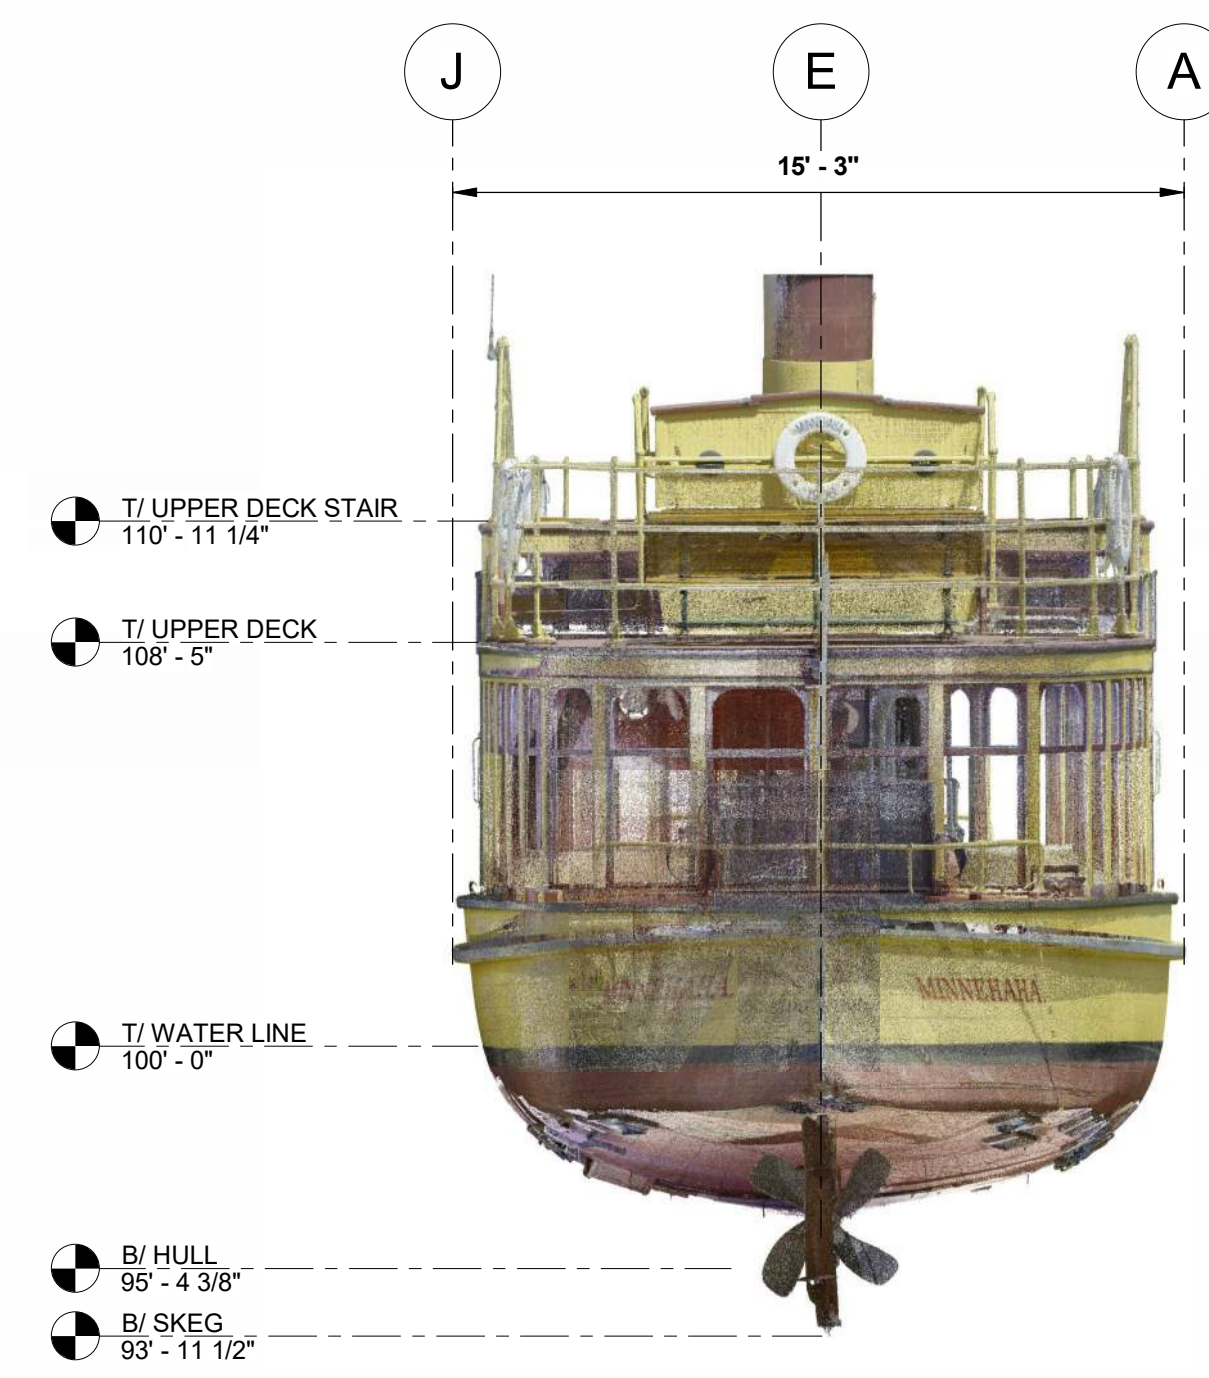

2 ELEVATION LOOKING AT STEARN
1/4" = 1'-0"

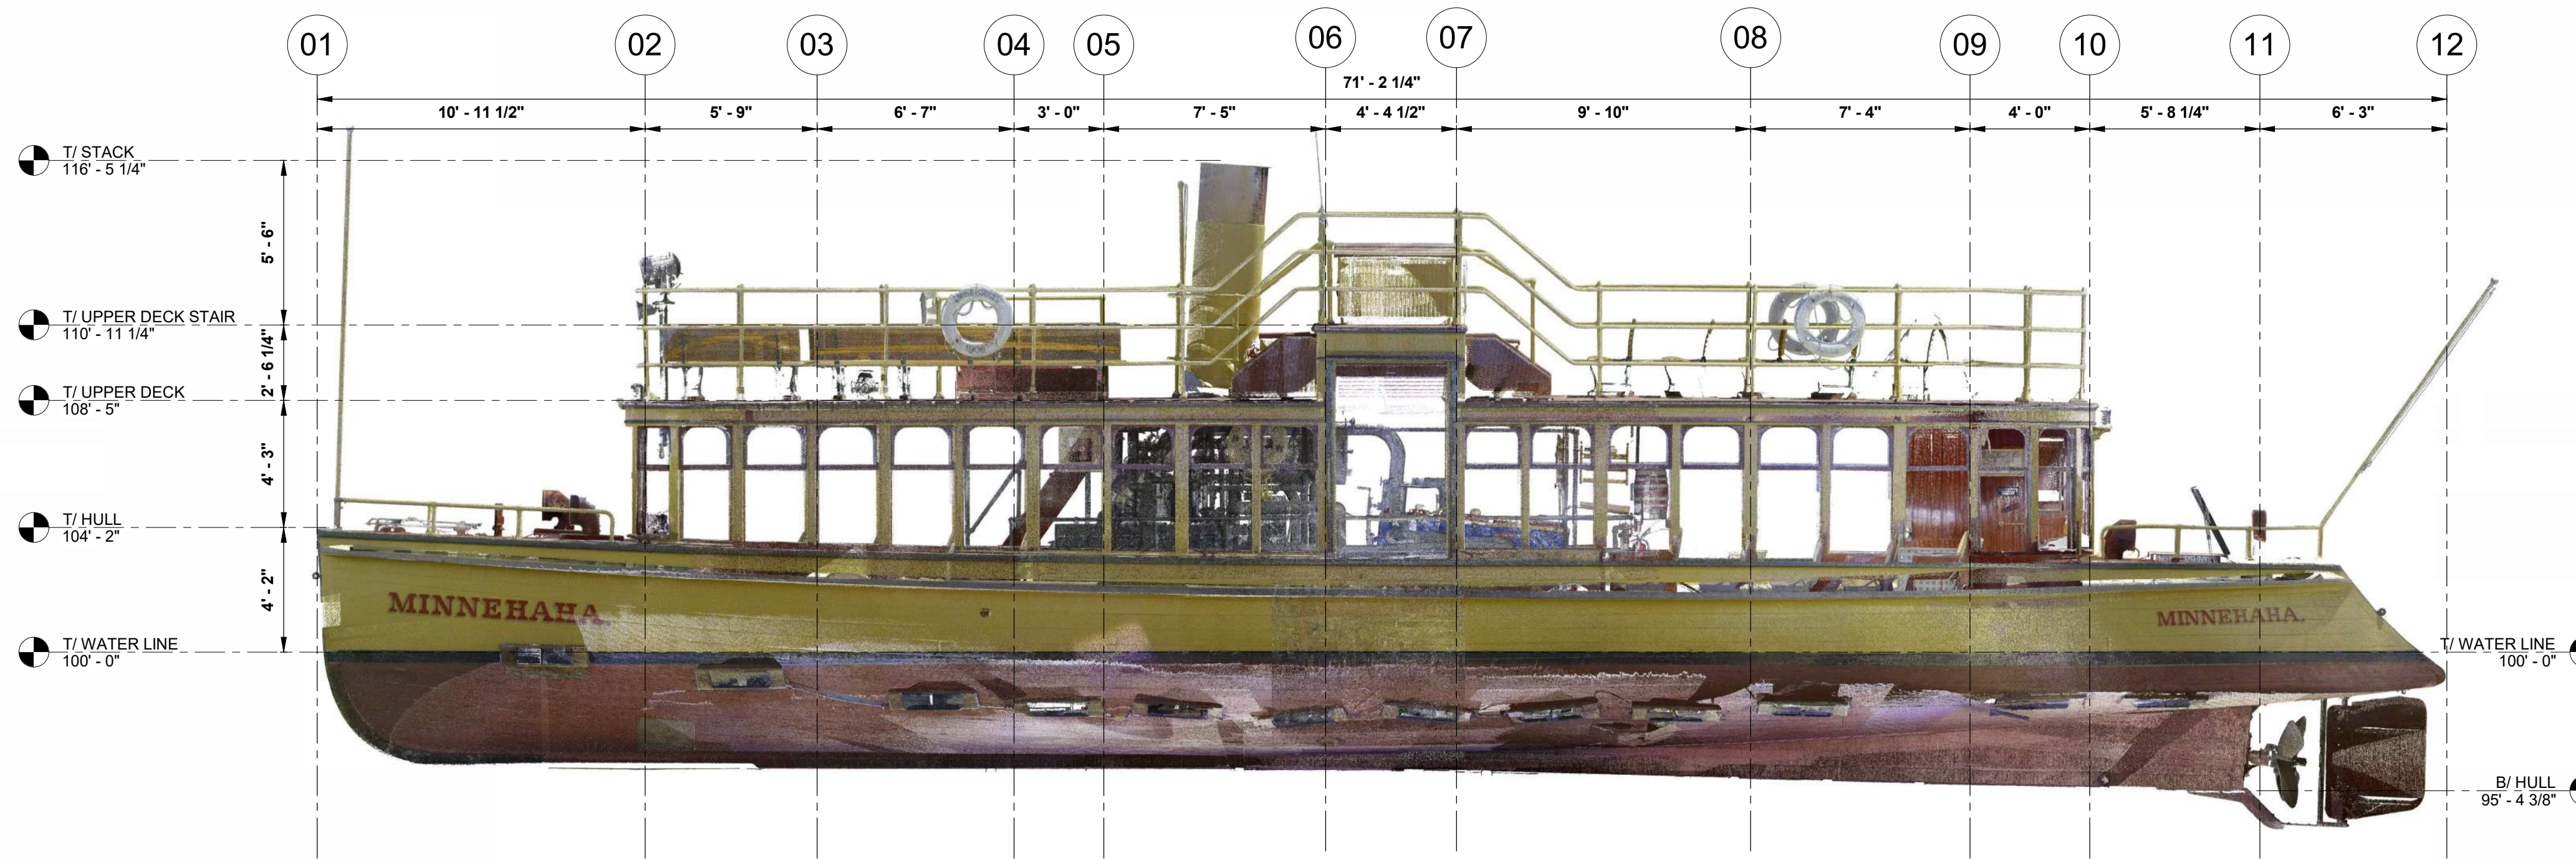

3 ELEVATION LOOKING AT PORT SIDE
1/4" = 1'-0"

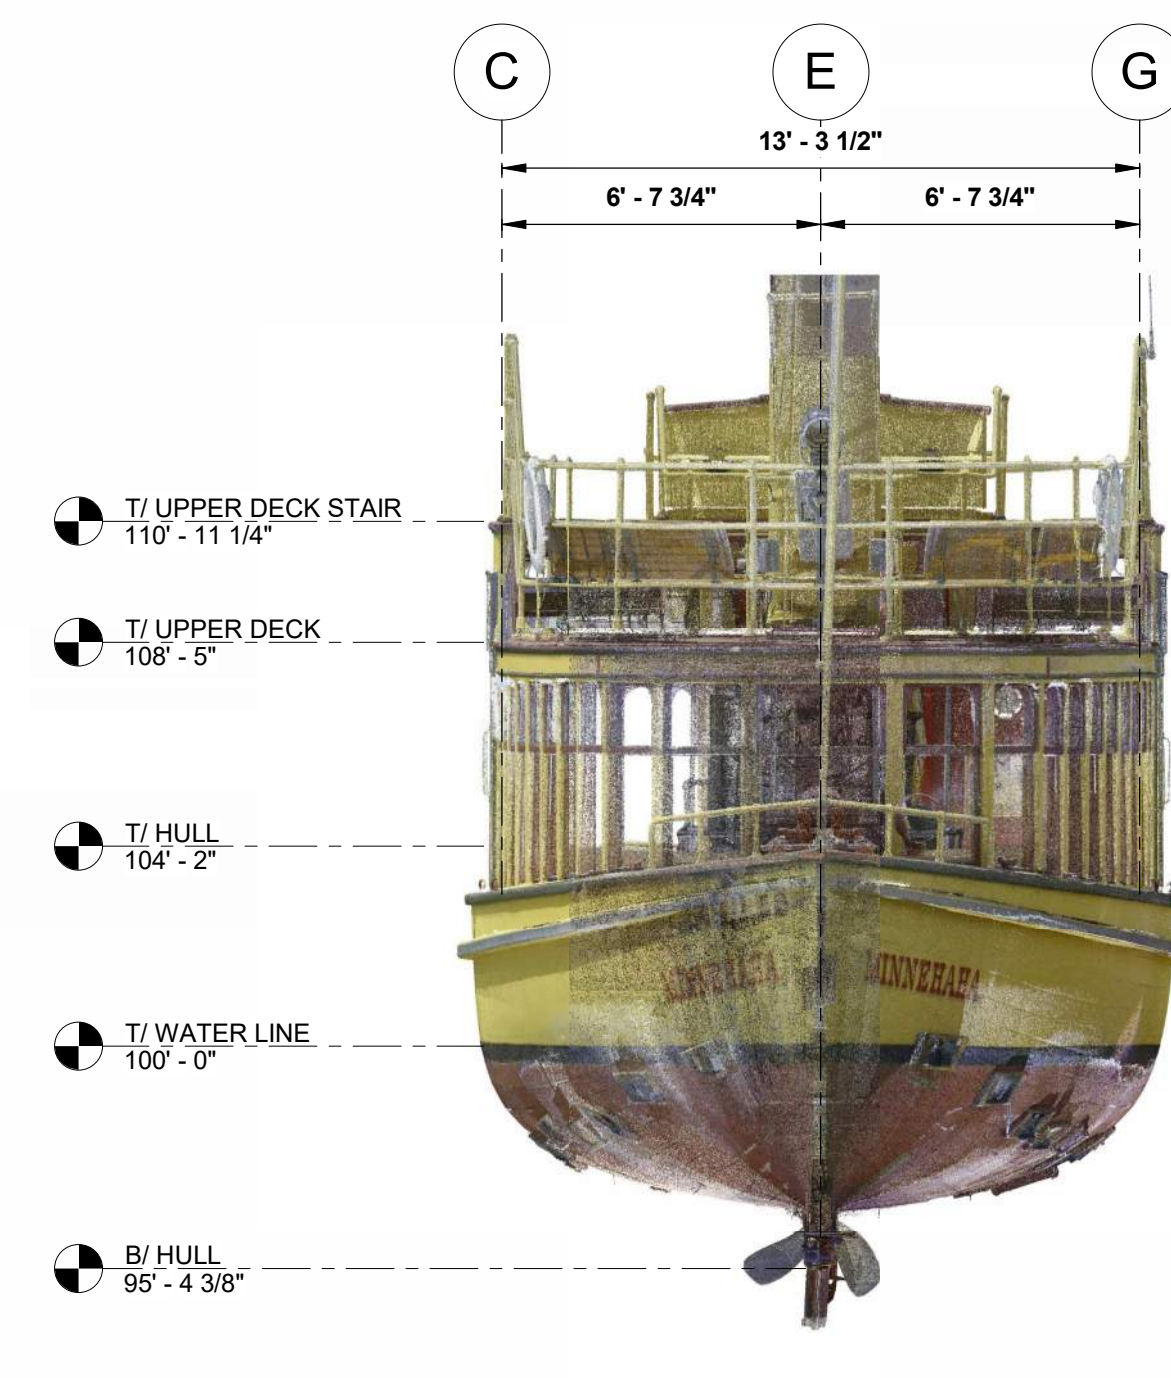

4 ELEVATION LOOKING AT BOW
1/4" = 1'-0"

REV. DATE:	15SEP23
REV. DESCRIPTION:	SCAN DATE - MAY 2022
REV. NO.:	0
PROJECT NO.:	23018
PROJECT NAME:	STREET CAR BOAT "MINNEHAHA"
CLIENT:	LAKE MINNETONKA MUSEUM
PROJECT ADDRESS:	EXCELSIOR, MINN
SHEET NO.:	EX05
ELEVATION VIEWS	

SCANSTAR
DATA DRIVEN & GEOSPATIAL SOLUTIONS

DRAWN BY:
Dan Starr & Jason Meyer
O: 763-276-1035
quote@scanstarllc.com
11040 183rd Circle NW
Suite AA
Elk River, MN 55330
scanstarllc.com

o Pointclouds
o Bid Documents
o Site Mapping
o Resource Management

APPROVED BY:

STEAMBOAT
MINNEHAHA
1906